

UPDATE RELOCATION CAR PARK

FD1

REVISED TOILET DOOR AND RETAIL
UNITS ACCORDING TO SPA
DRAWING.

E.F.L. +3.500

RETAIL 20.50

RET
153

MH 4 VISITOR PARKING


MATERIAL SPEC. AS PER
LANDSCAPE ARCHITECT

R.L. +2.500


② ~~Life cycle~~ 10×10 will be 100 instead of 10 2 $2a$

(2) ~~11475~~ 11475 instead of 7620


3. level a

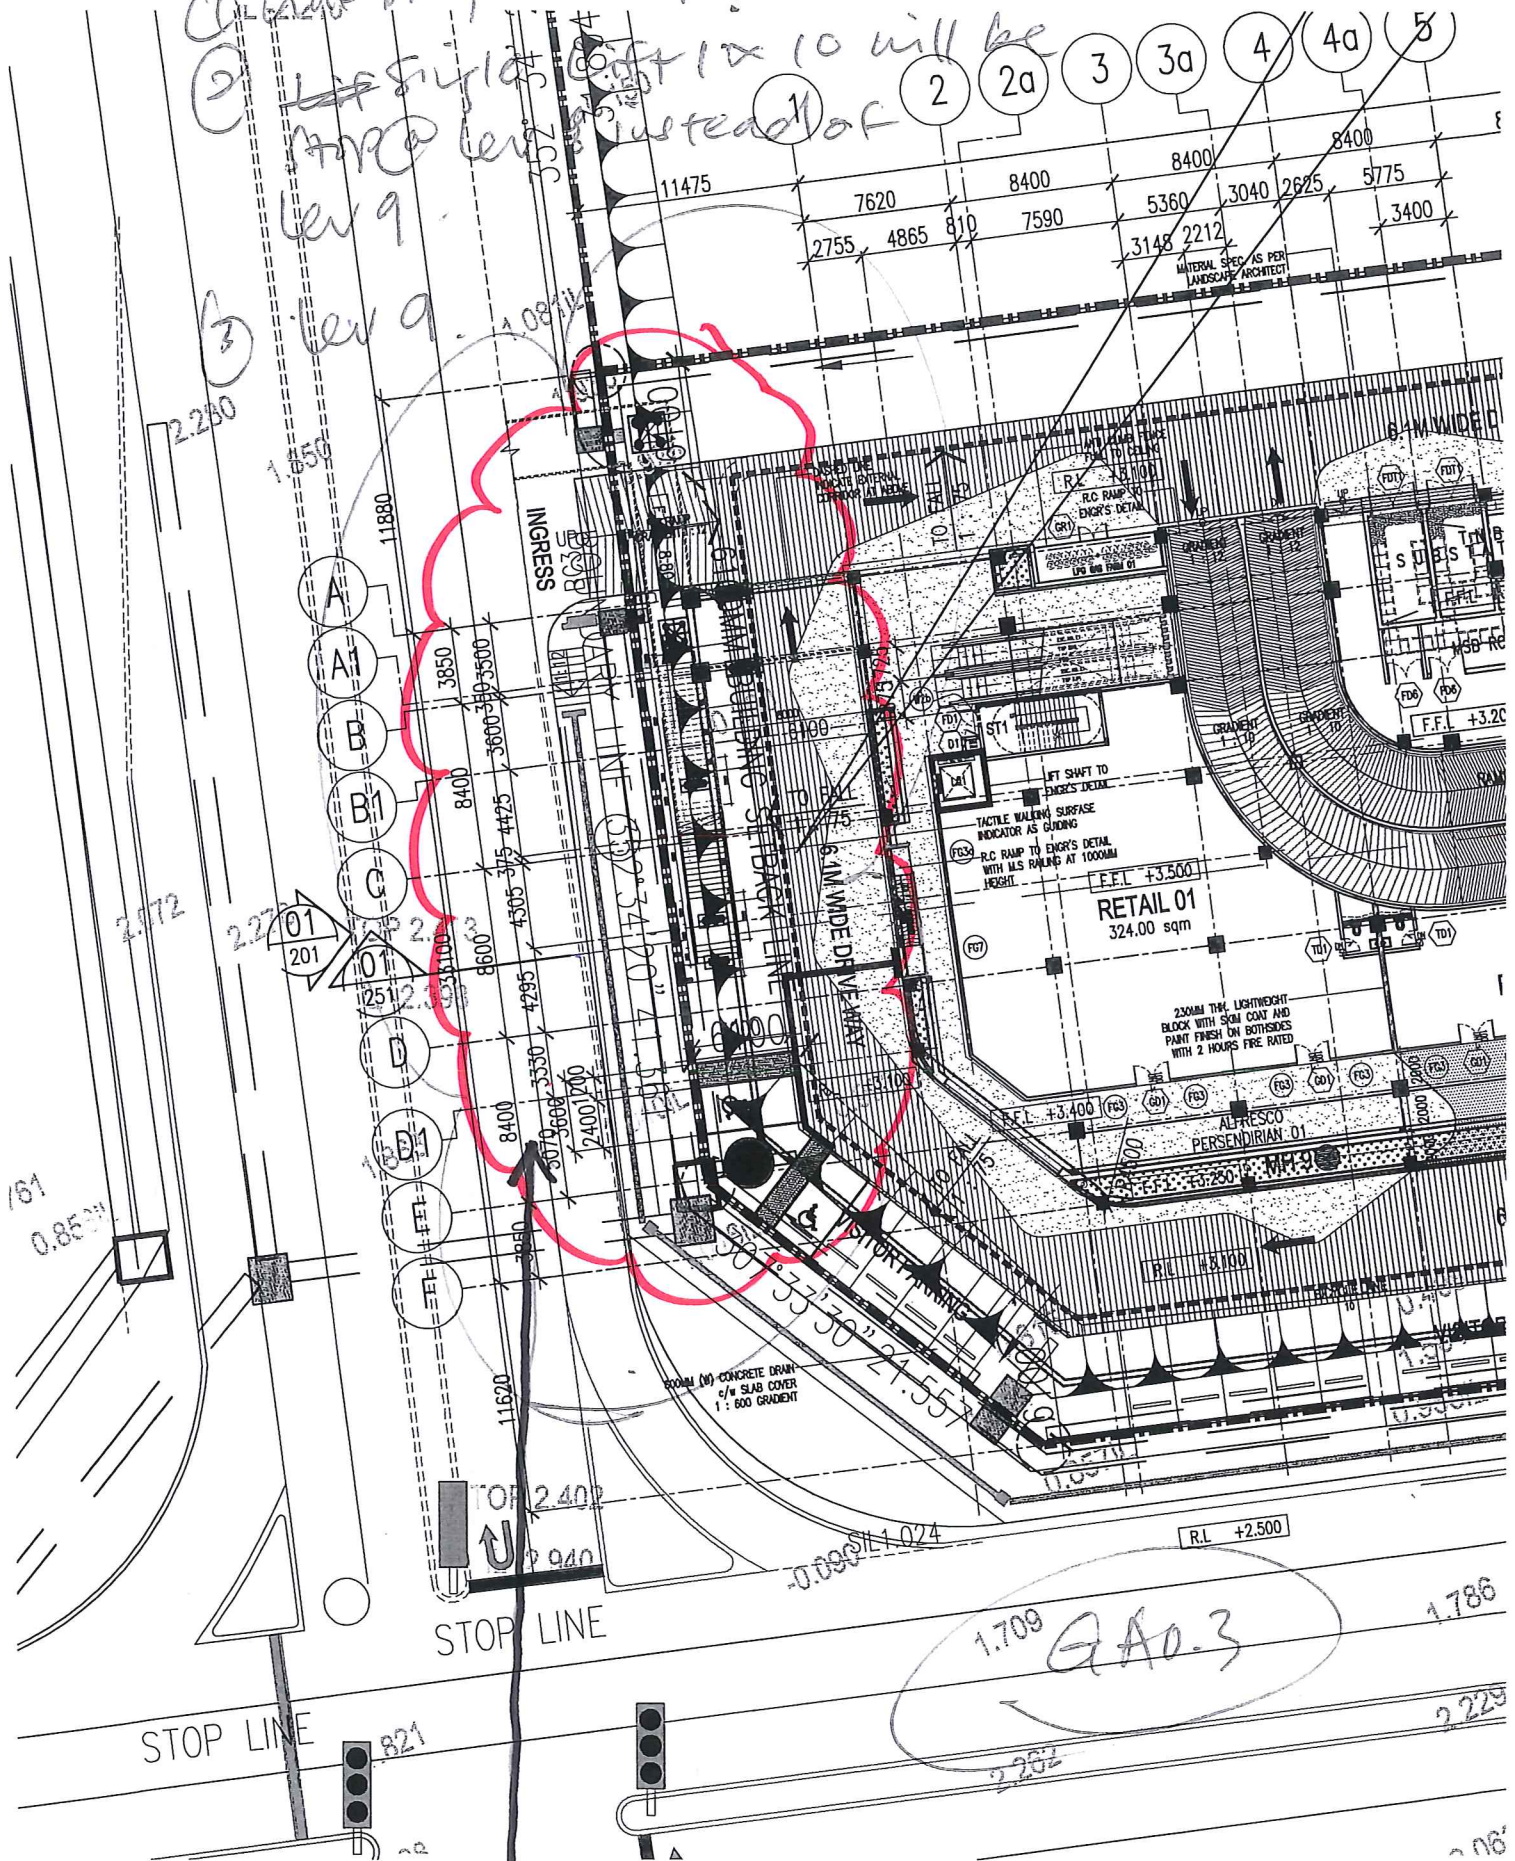

TO UPDATE FINAL LINK BRIDGE
WITH LFT

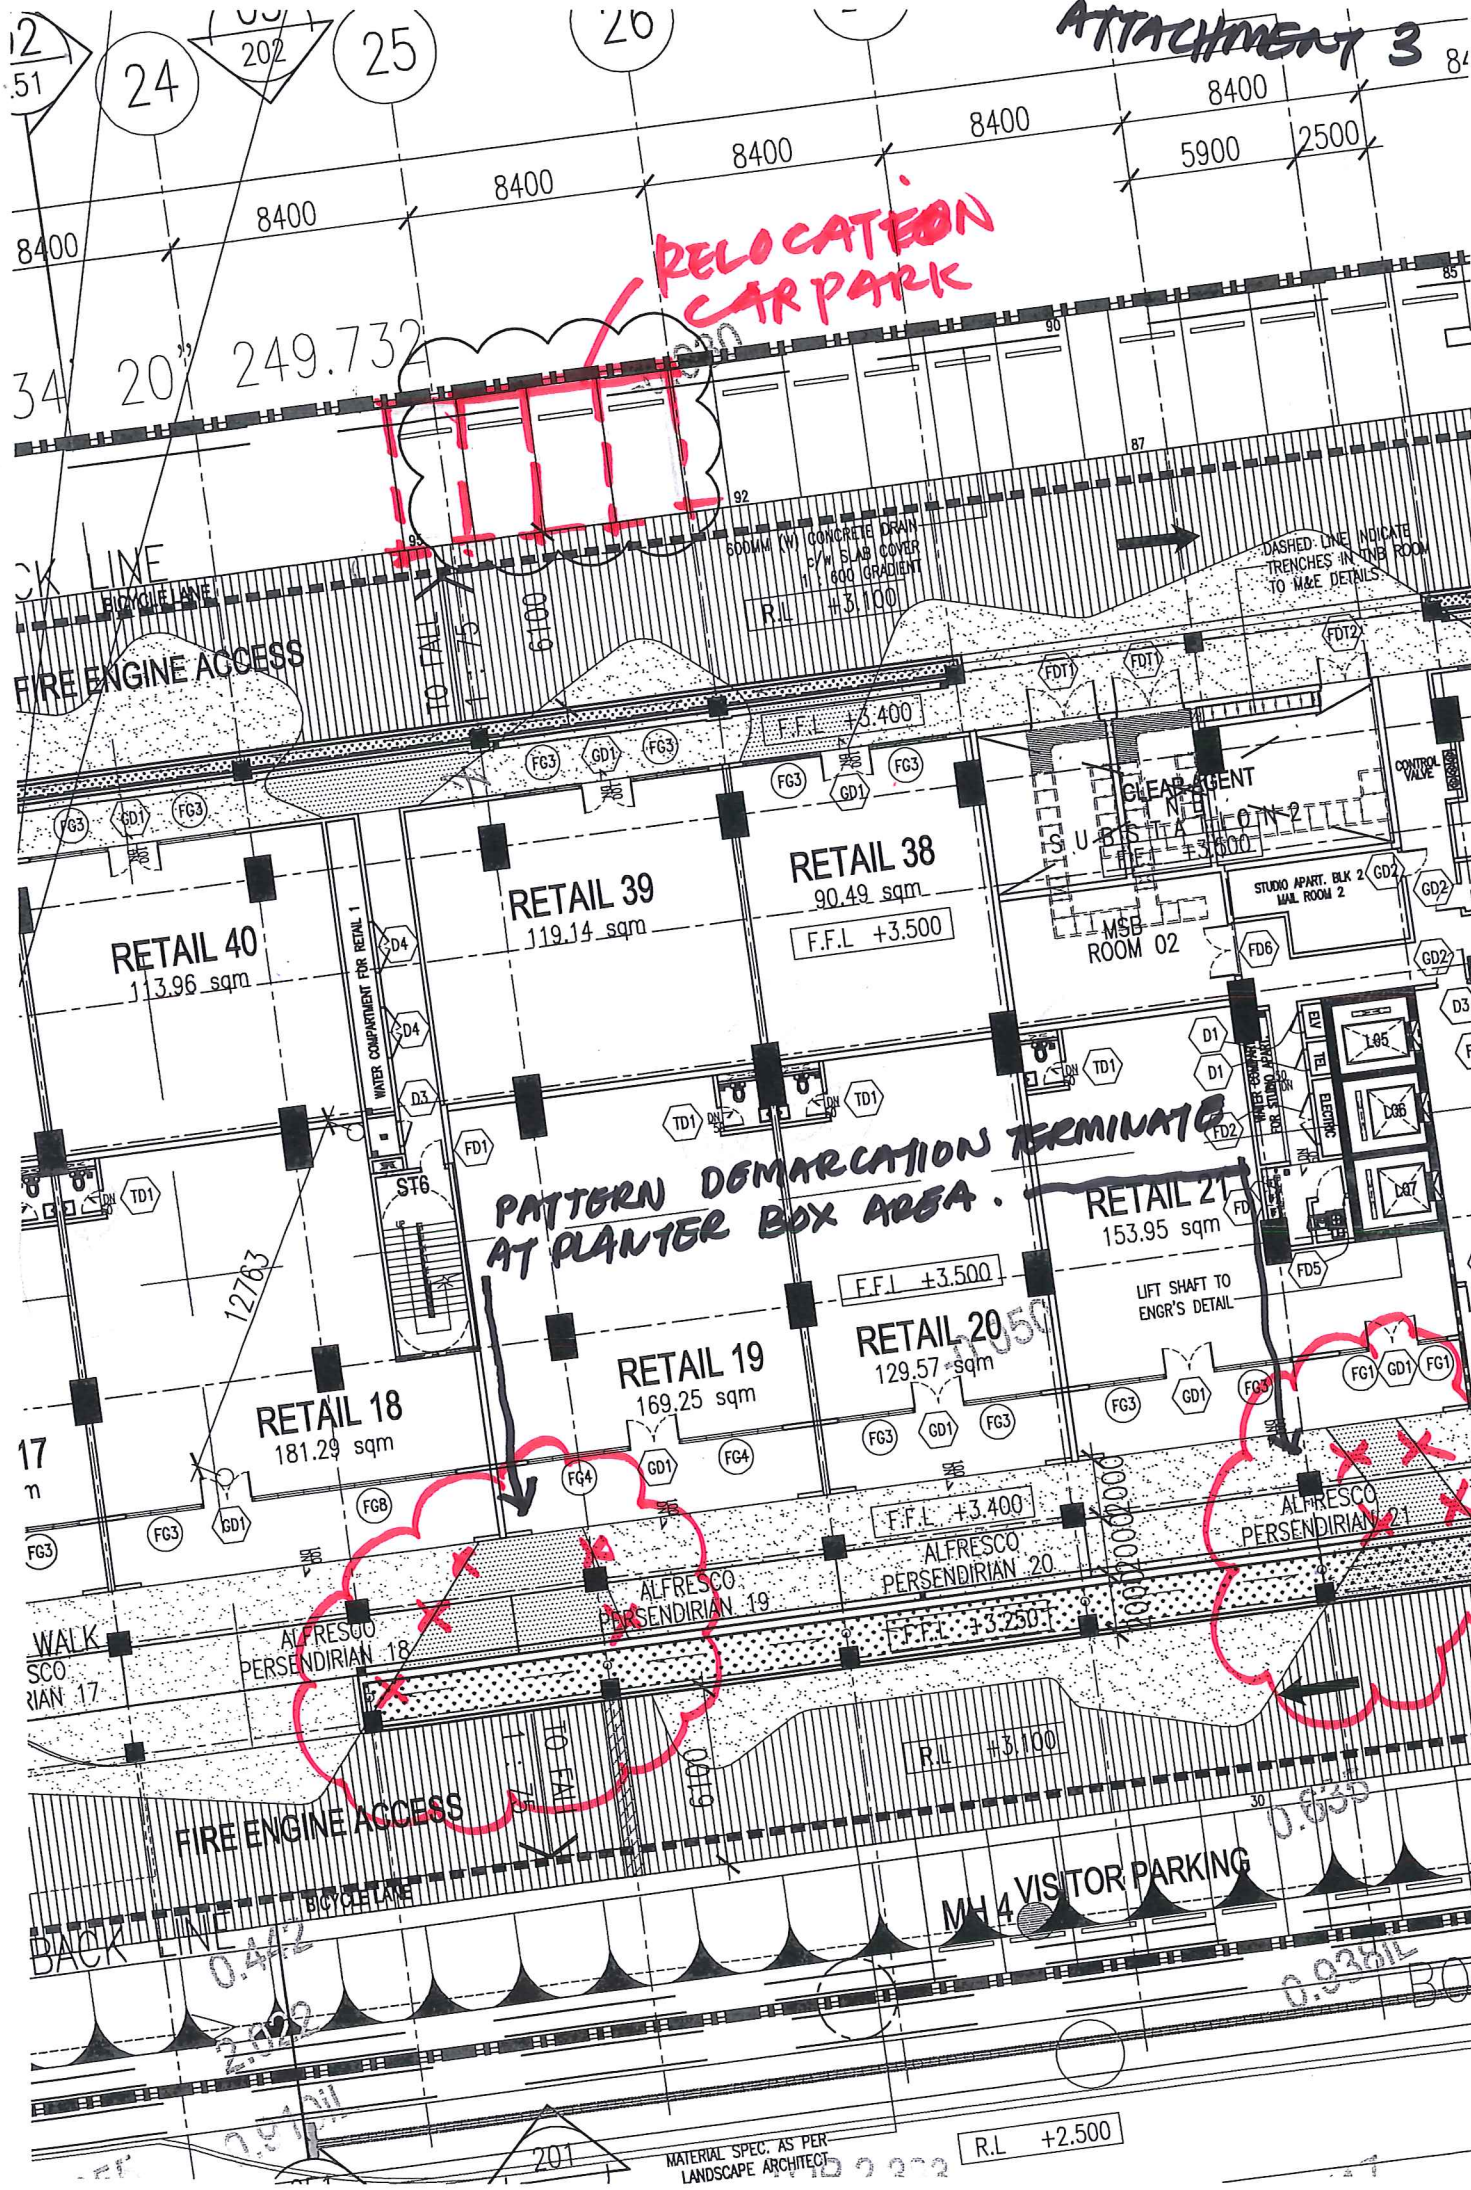

PRIMARY INLET AND

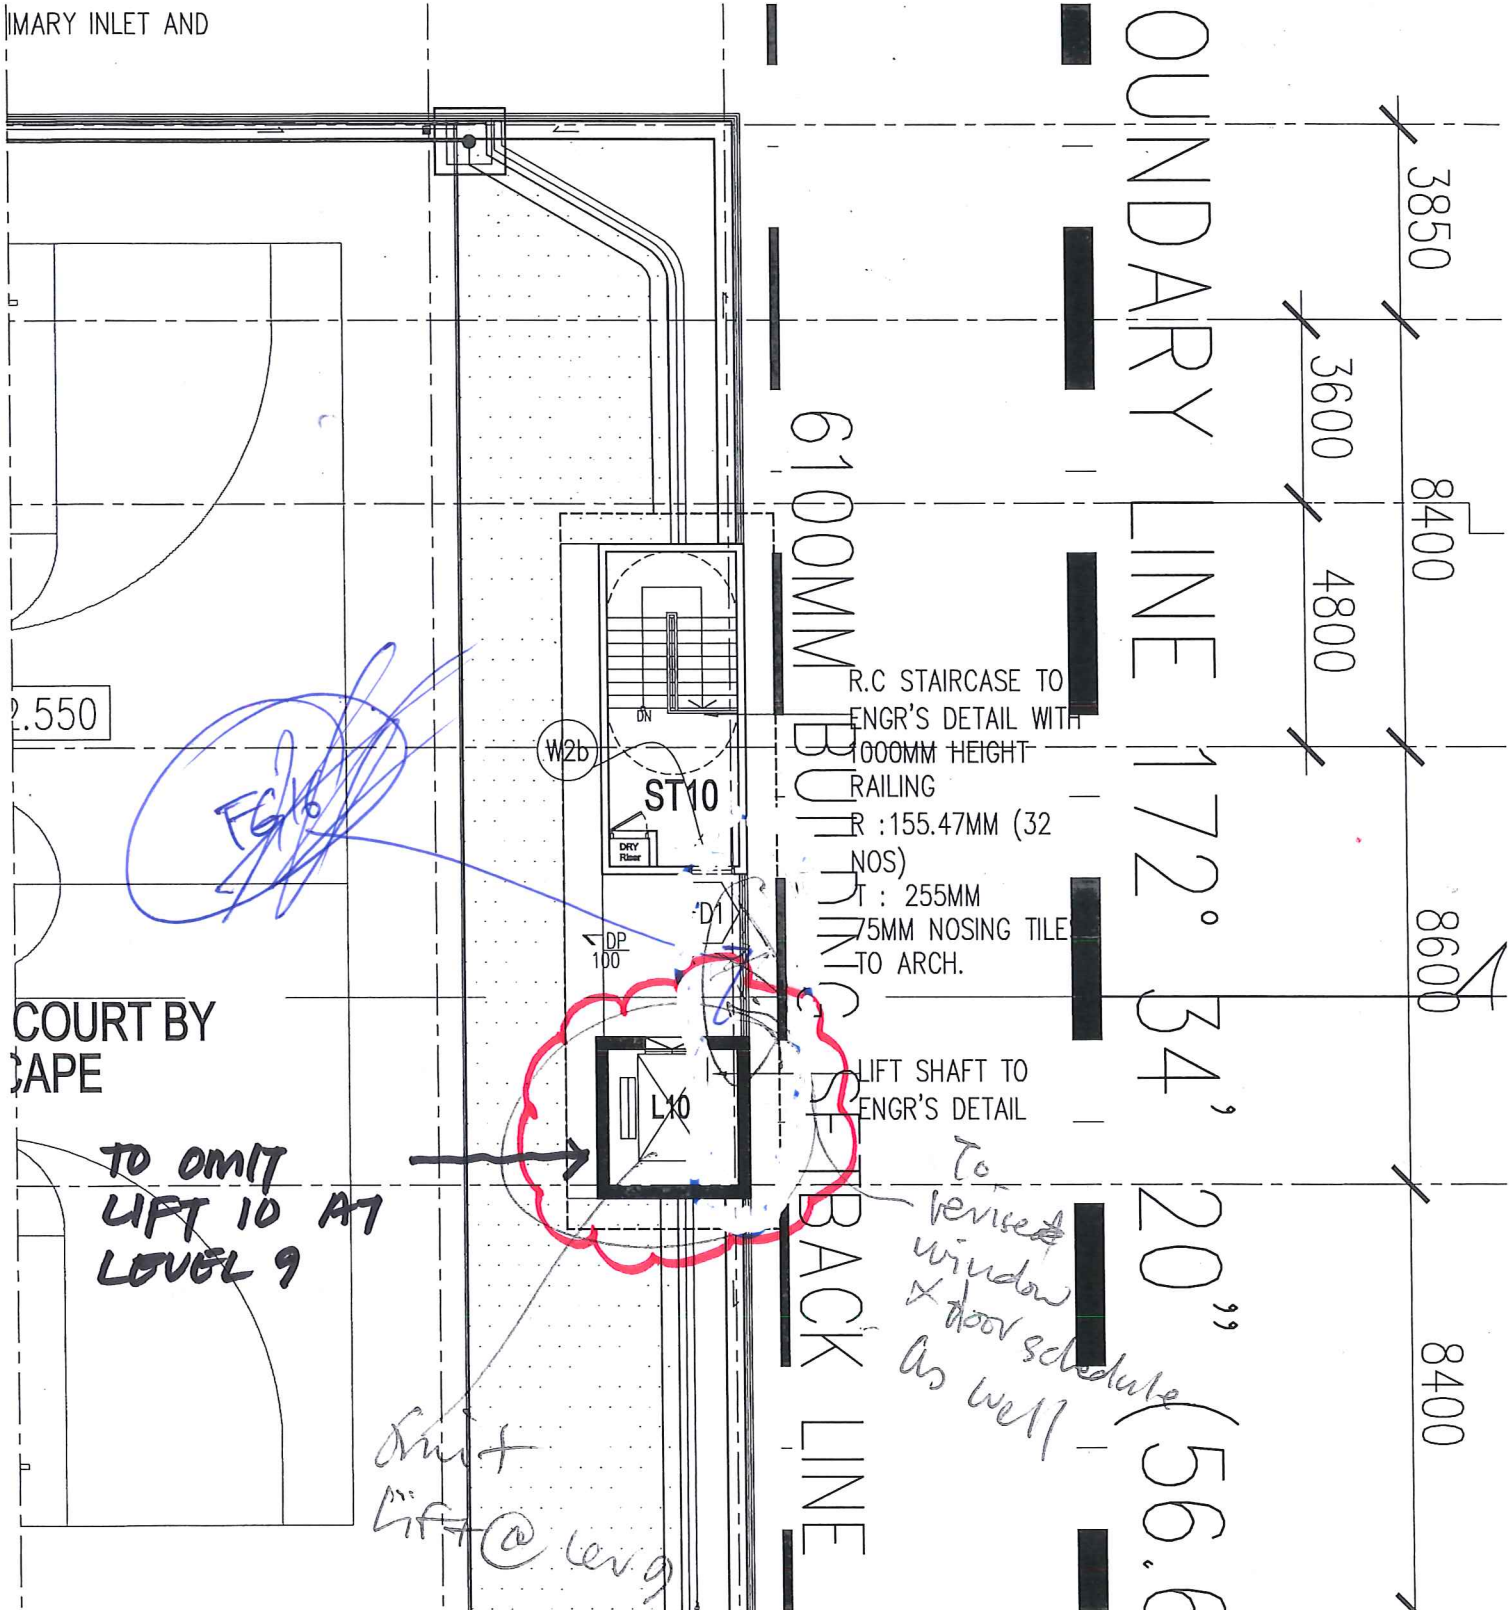

2.550

COURT BY CAPE

TO OMIT
LIFT 10 AT
LEVEL 9

Shift
Lift @ lev. 9

R.C STAIRCASE TO
ENGR'S DETAIL WITH
1000MM HEIGHT
RAILING
R : 155.47MM (32
NOS)
T : 255MM
75MM NOSING TILE
TO ARCH.

LIFT SHAFT TO
ENGR'S DETAIL


To
revised
window
& door schedule
as well


BOUNDARY LINE 172' 34' 20" (56.6)


6100MM BUILDING BACK LINE

ATTACHMENT 05

ABP
Construction
A.O.C.

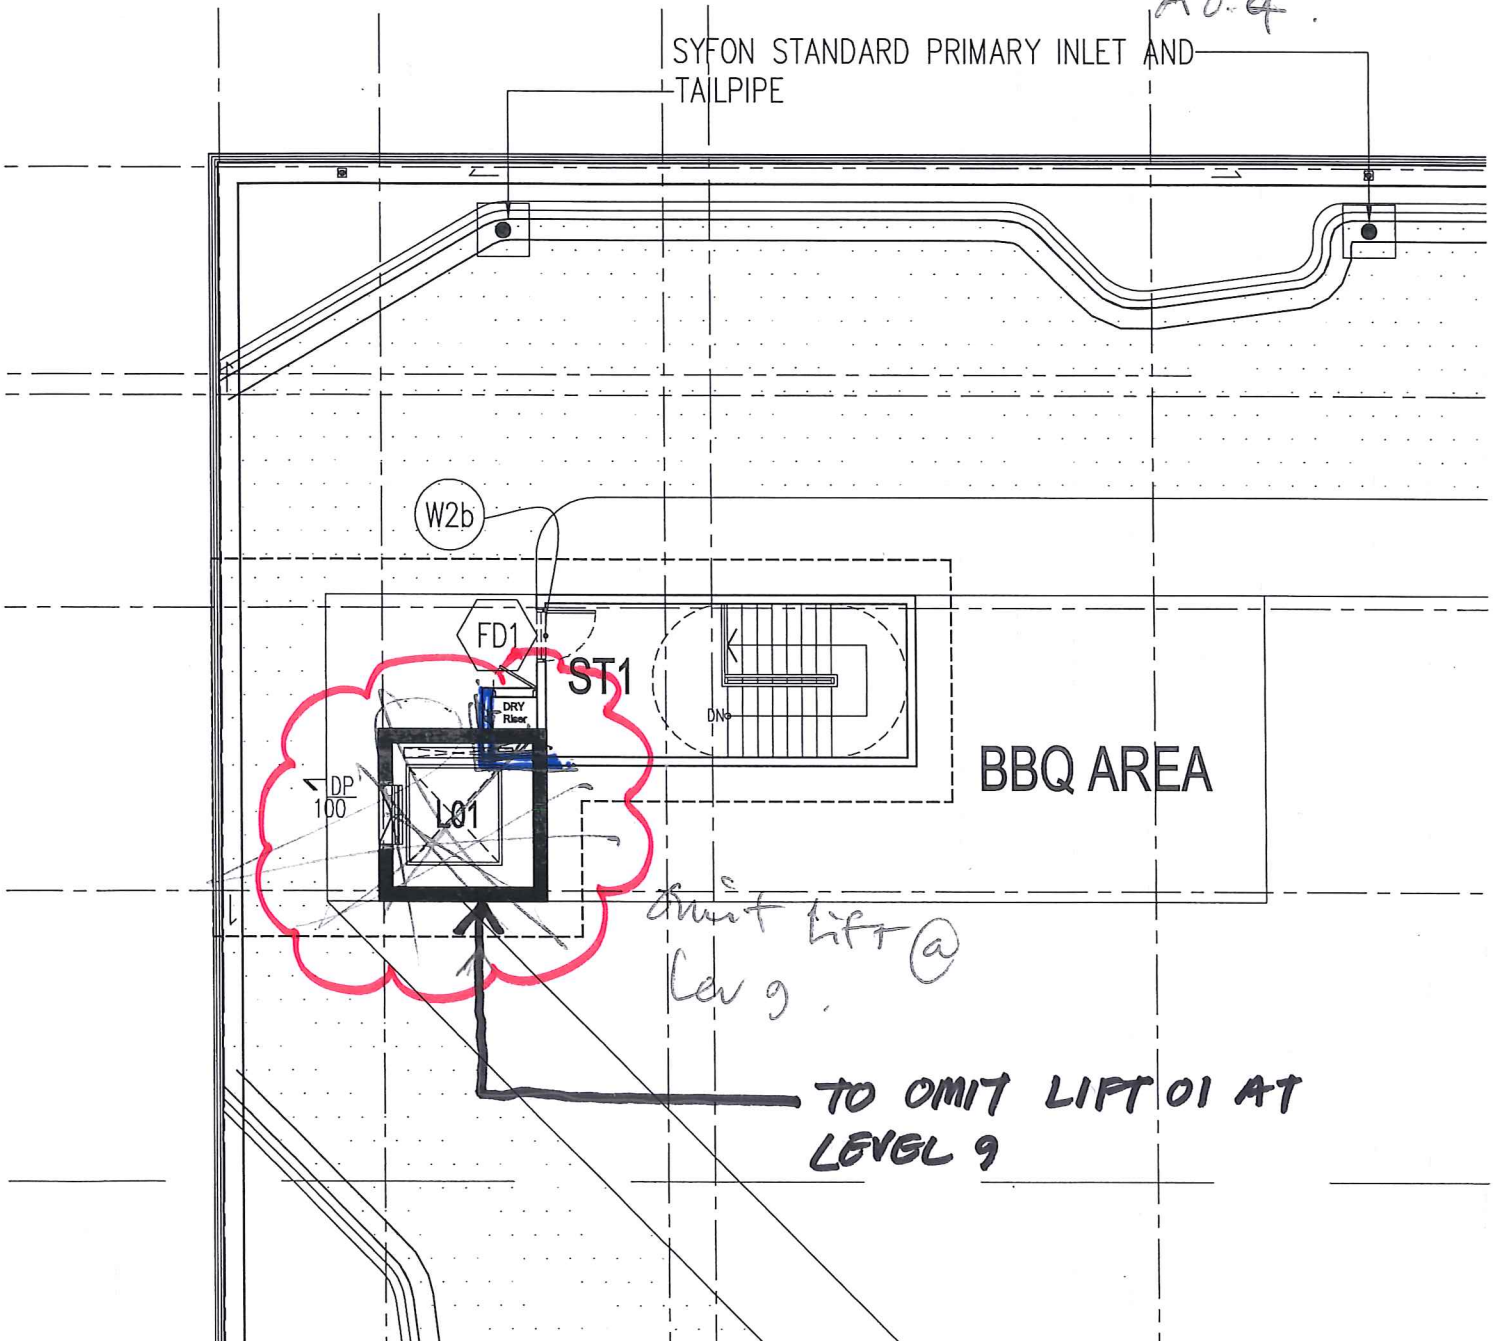


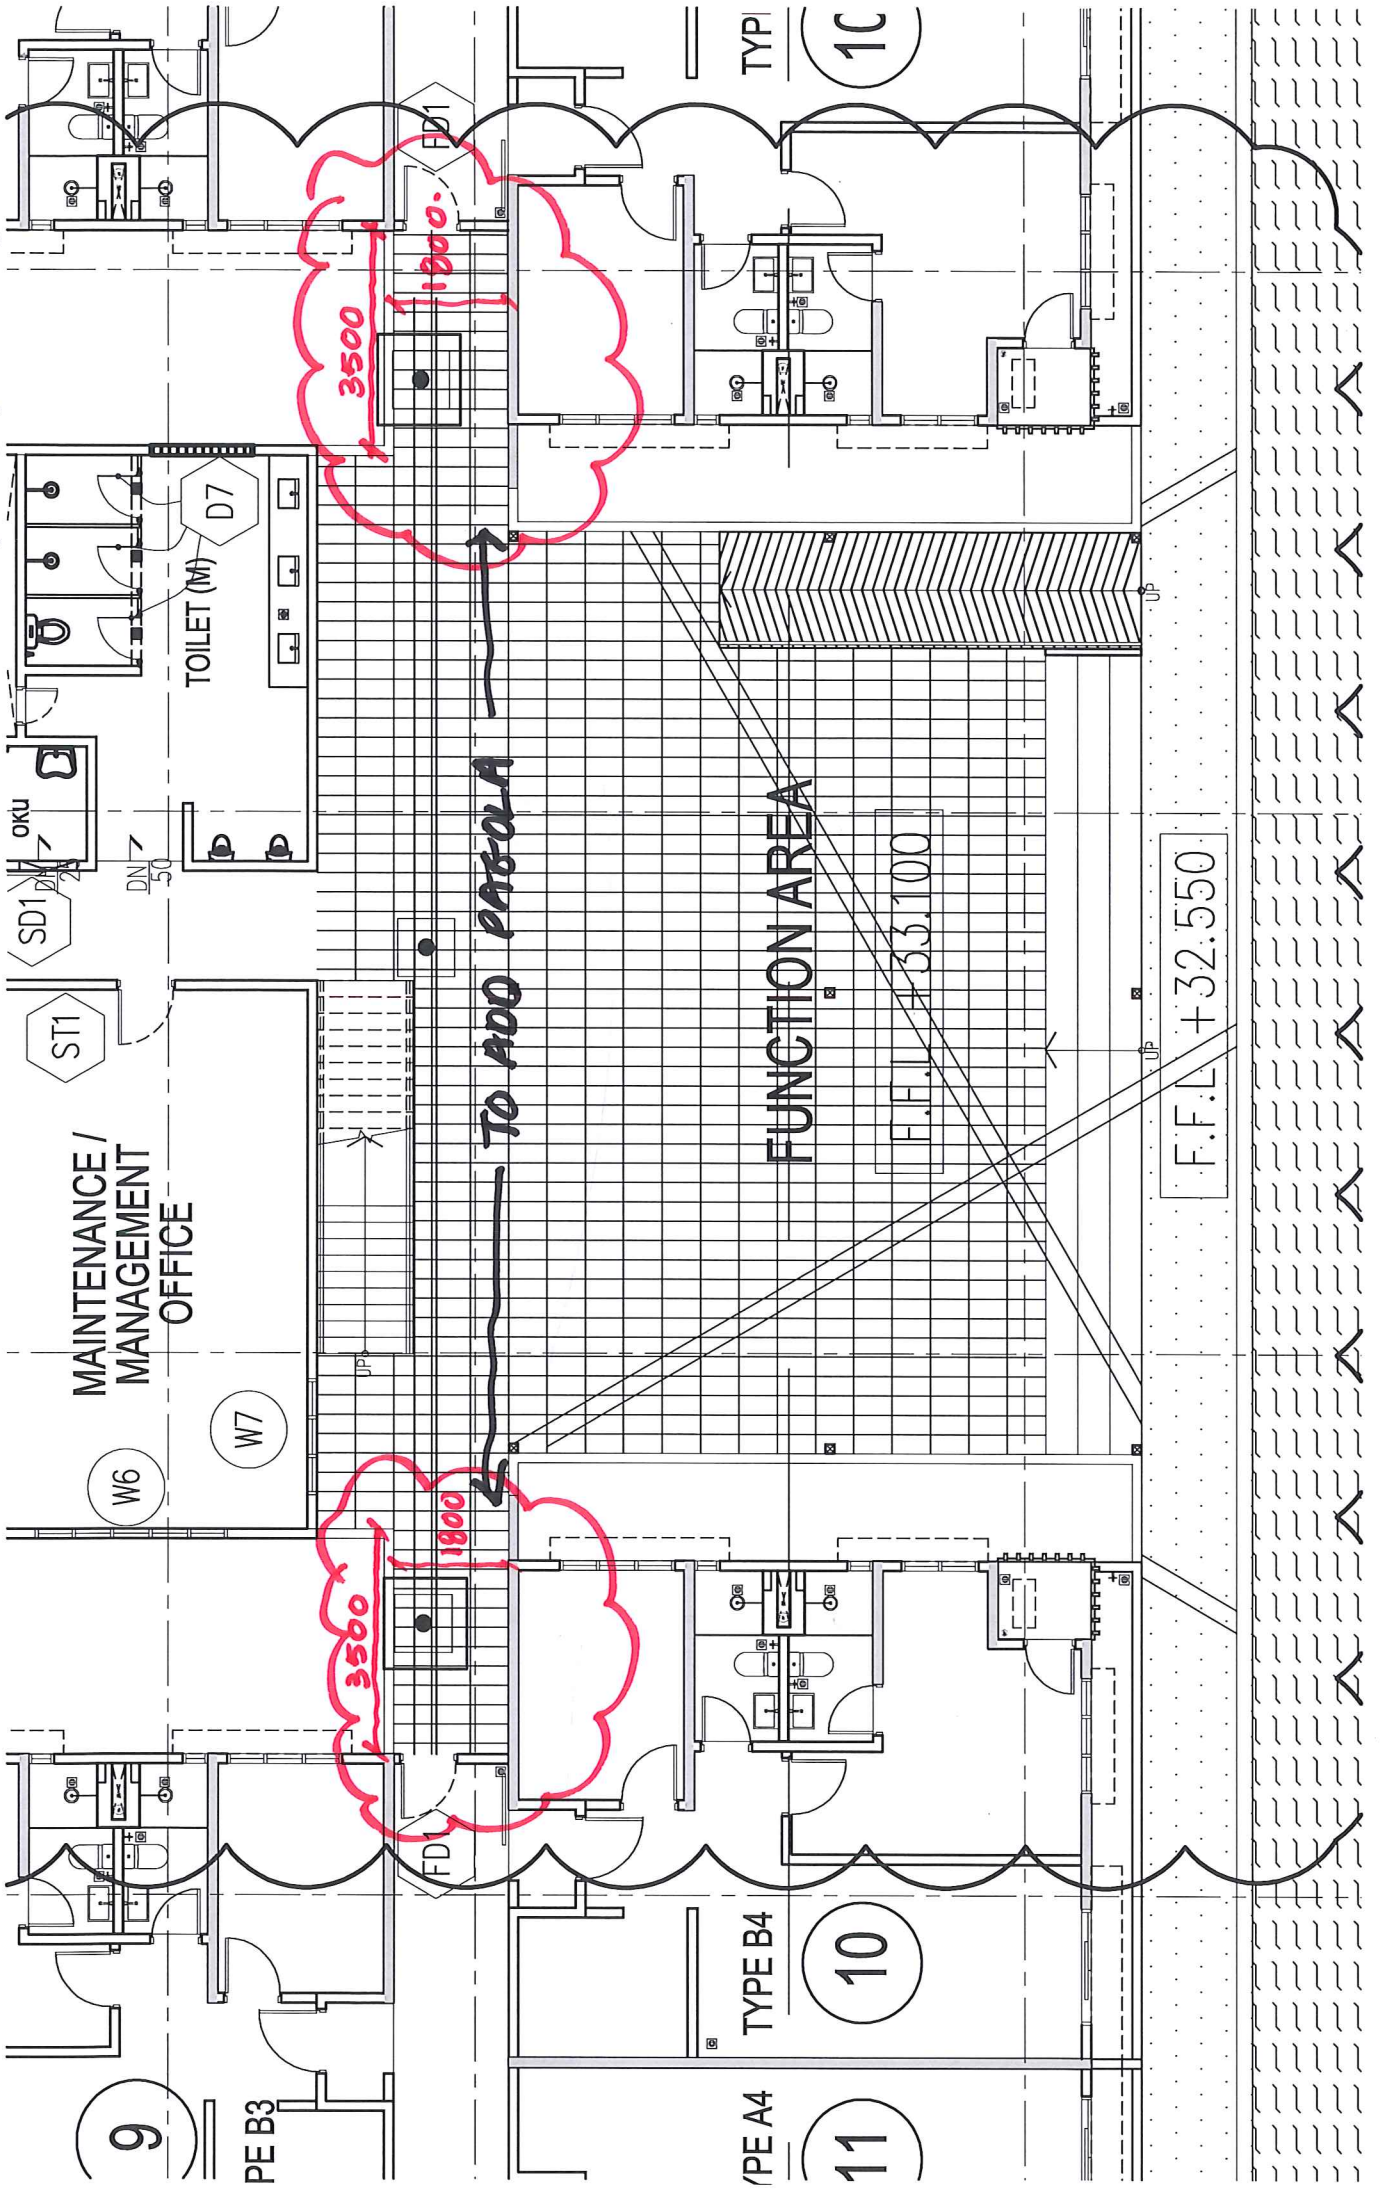

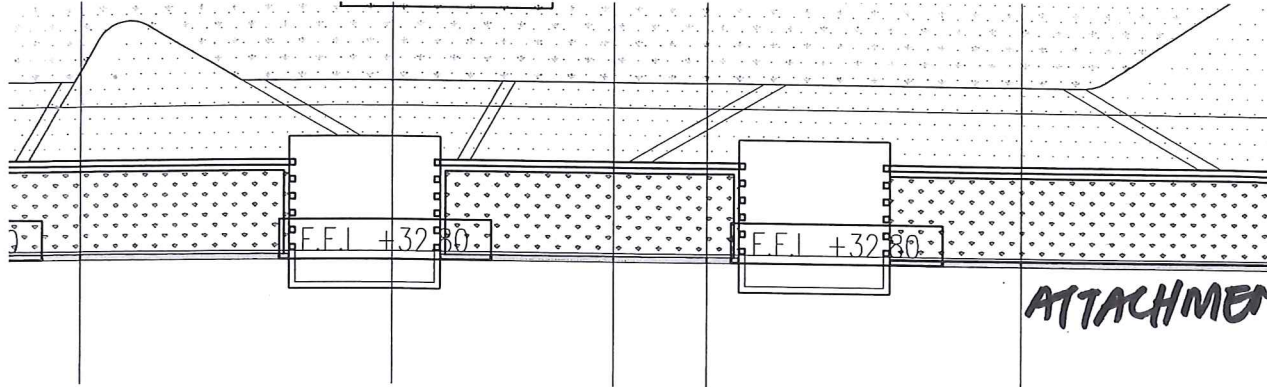

ATTACHMENT 6 B.

ENLARGEMENT PLAN
PODIUM LANDSCAPE
SCALE 1 : 200

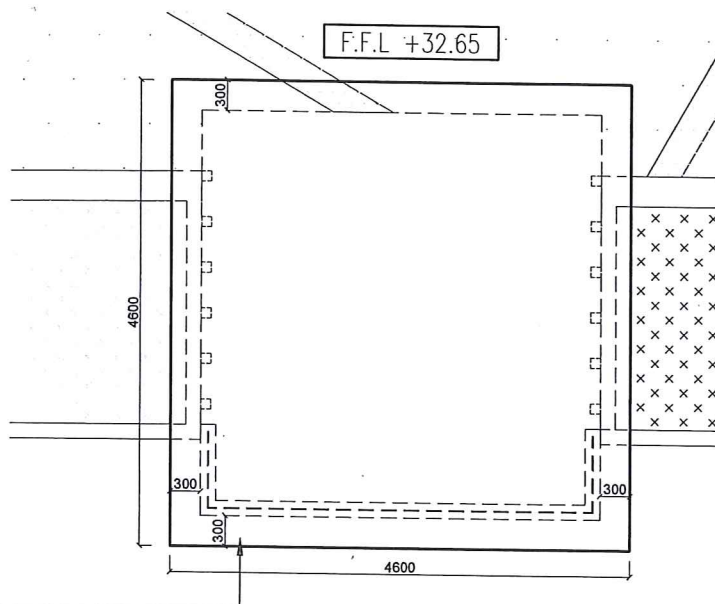


s pattern
mm width

our

eel
green
if.

CABANA
ROOF PLAN
SCALE 1 : 75

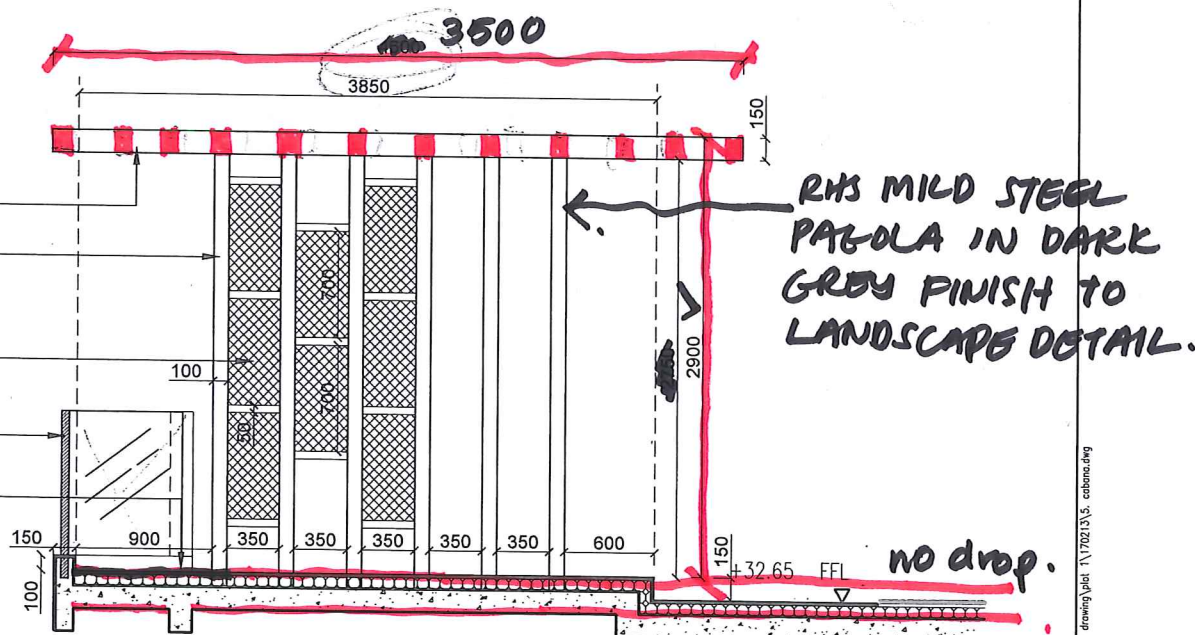

CABANA
TYPICAL SECTION E2-E2'
SCALE 1 : 50

DRAWING STATUS AND DATE :

CONSTRUCTION
DRAWING


1 MARCH 2017

DATE	REVISED	REF.	SCALE : AS SHOWN	A3	DRAWING NO :	REV.
			UNIT : MM		LA-15052-HD-PD-13	01
			DATE : 10 FEBRUARY 2017		SHEET NO.	PROJECT NO.
			DRAWN BY : AINI		20	15052
			CHECKED BY : ATIF		38	
					FILE :	
					5. CABANA.DWG	

This drawing may not be reproduced or used without the written permission from LANDART DESIGN

z:\landart project\15052 (db) - utropolis_poremaun\1_lander drawing\plot 1\170213\5. cabana.dwg


ATTACHMENT 07

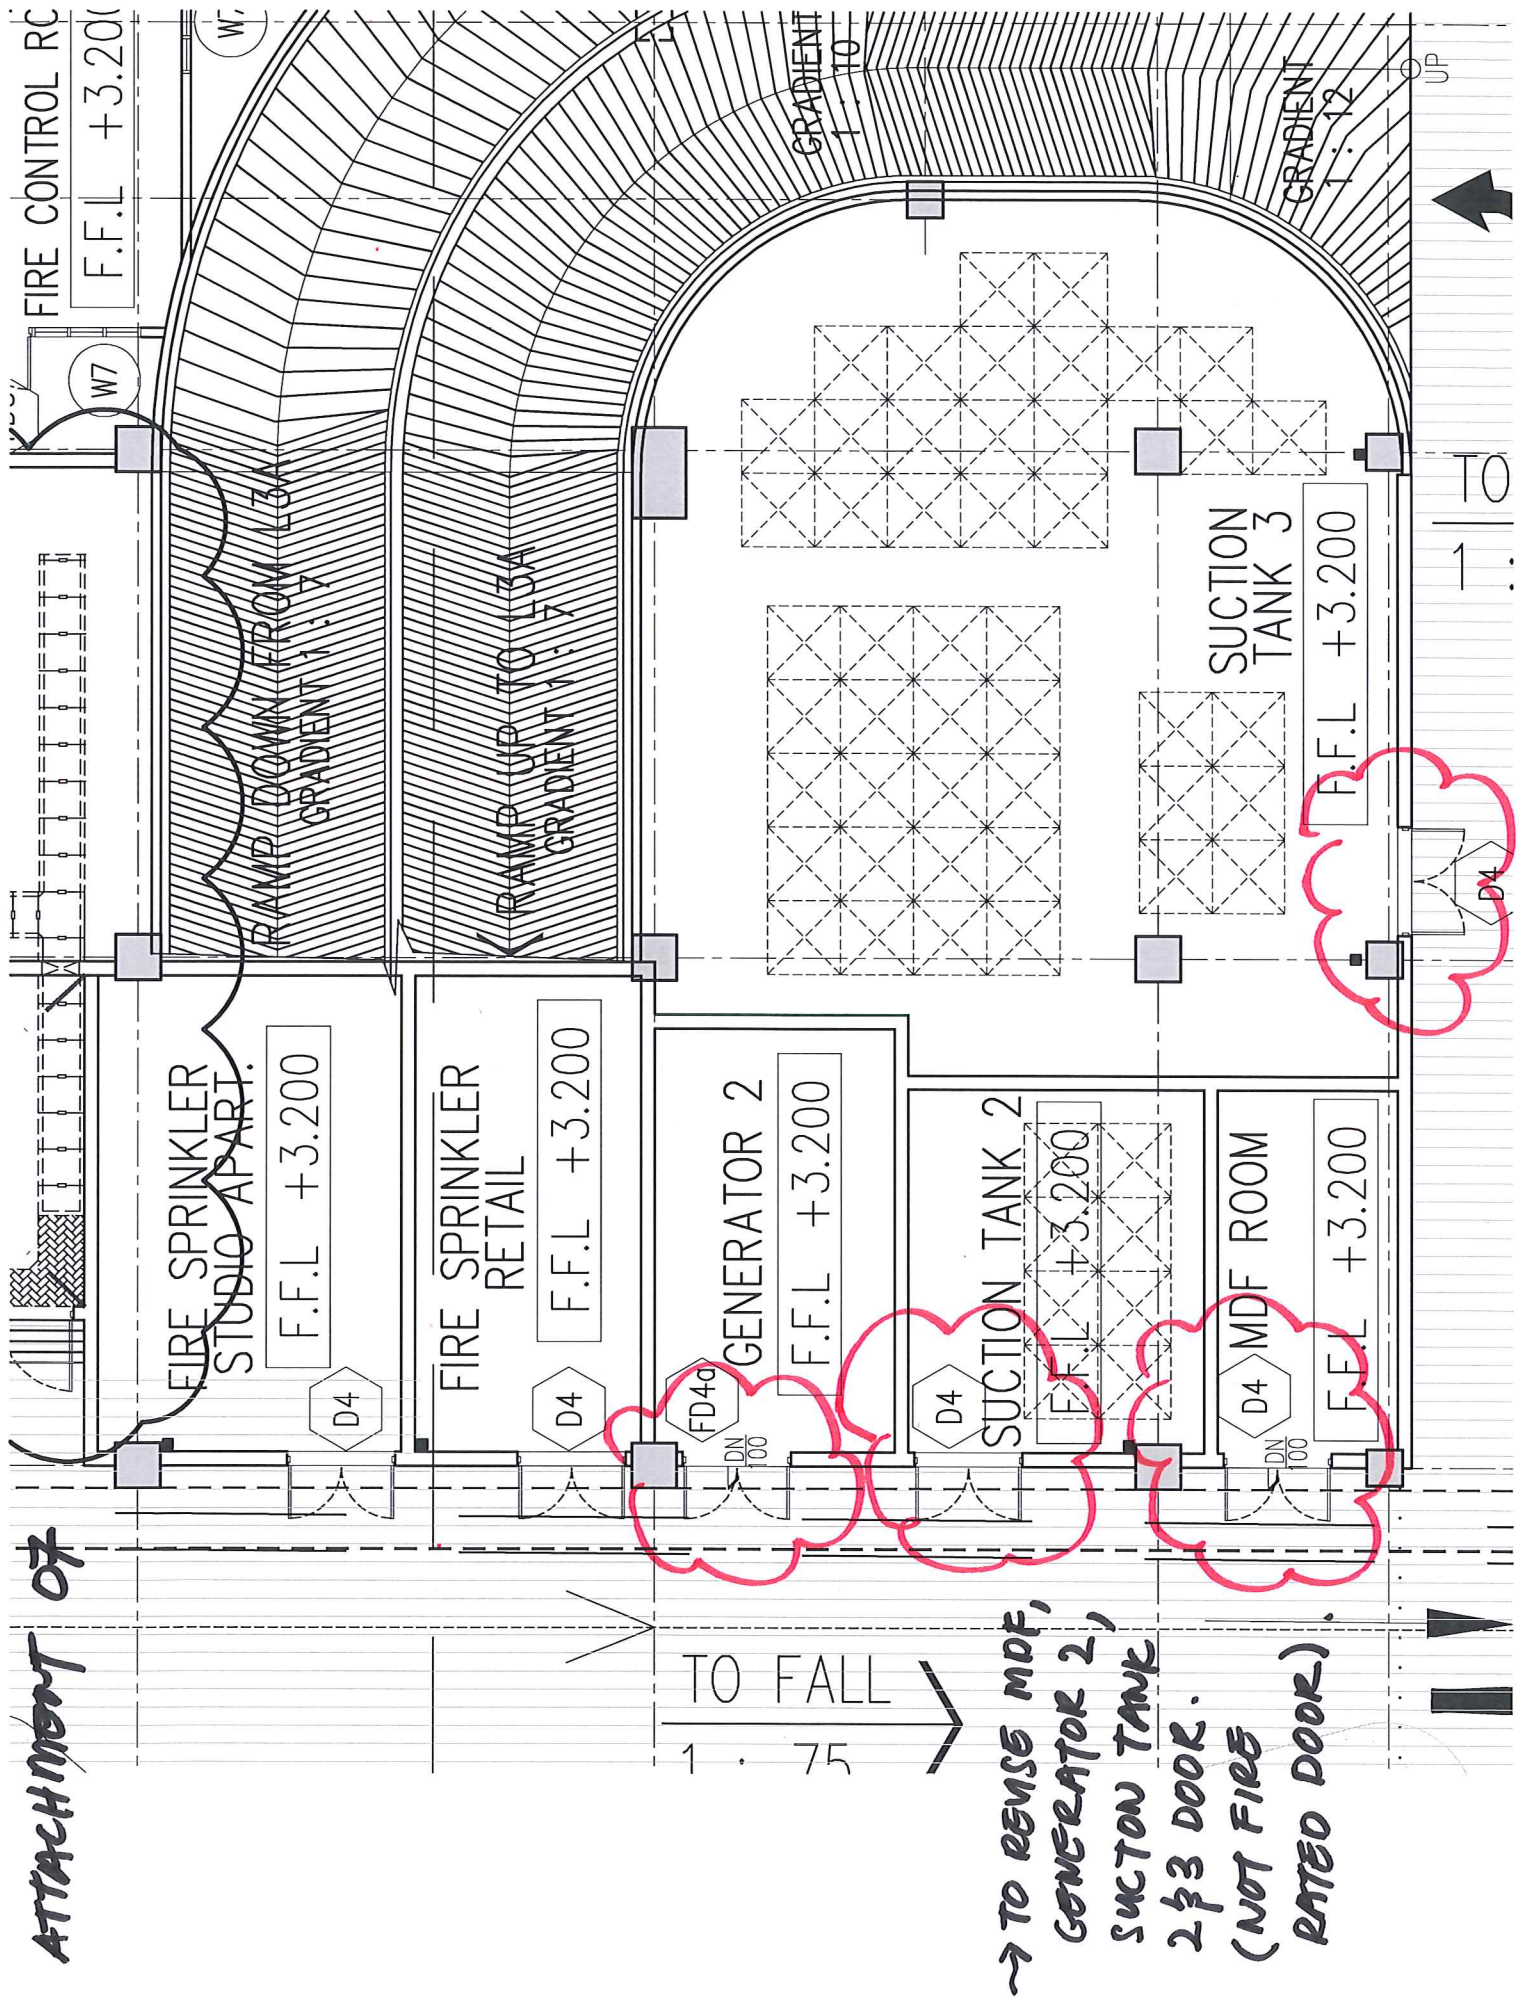



Planter box and water proofing (by others)

Feature seating w/ r.c structure to be attached to r.c planter box w/ concrete sandwashed finish in Brown colour

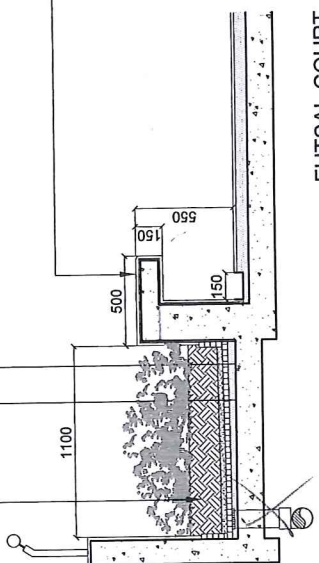

FUTSAL COURT
ENLARGEMENT OF DETAIL A2
SCALE 1 : 30

 LANDART d e s i g n s 42-400-2209 10000 42-400-2209 277 200 Fax: 400-2209 10000 42-400-2209 277 200 Fax: 400-2209 10000		PROJECT PLOT 1 LANDSCAPE WORKS FOR CAJANGAN MEMANA PEMANGKUAN BERCAKUP DI ATAS LOT 21136, PERSIARAN GASMA BARAT 3, MUKIM 13, SEBERANG PERAI SELATAN, PULAU PINANG YANG BERKAITAN DENGAN PERSEKUTUAN PERUSAHAAN BERSEKUTUAN 18 TINGKAT (S/LC UNIT) A. KEDAI PERABOT 3 TINGKAT (S/LC UNIT) B. KEDAI PERABOT 3 TINGKAT (S/LC UNIT) C. STRUKTUR TEMPAT LETAK BERSEKUTUAN		SCALE 1 : 30 DRAWING NOT TO BE REPRODUCED OR USED WITHOUT THE WRITTEN PERMISSION FROM LANDART DESIGN REVE	
CLIENT PARAMOUNT PROPERTY (PW) SDN. BHD.		DRAWING STATUS AND DATE : CONSTRUCTION DRAWING 1 MARCH 2017		DATE REVISED REF.	
UNIT : MM DATE : 10 FEBRUARY 2017 DRAWN BY : ANI		SHEET NO. 03 PROJECT NO. 15052		SCALE : AS SHOWN A3 PROJECT NO. 15052-SC-PD-02	
CHECKED BY : ATIF FILE : 01- MASTER PLAN & SCISSORING		01- MASTER PLAN & SCISSORING		01- MASTER PLAN & SCISSORING	